


Copyright is reserved by Udrance Planning Ltd and the drawing is made on the condition that it is not copied, reproduced, retained, or allowed to any unauthorised person, either in part or without consent in writing.
Any discrepancies must be reported to the Agent, if in doubt, ask.
Planning Stage Drawing Only: Features to approximate locations, do not represent actual locations. Topographical Survey Required to establish exact vision points.

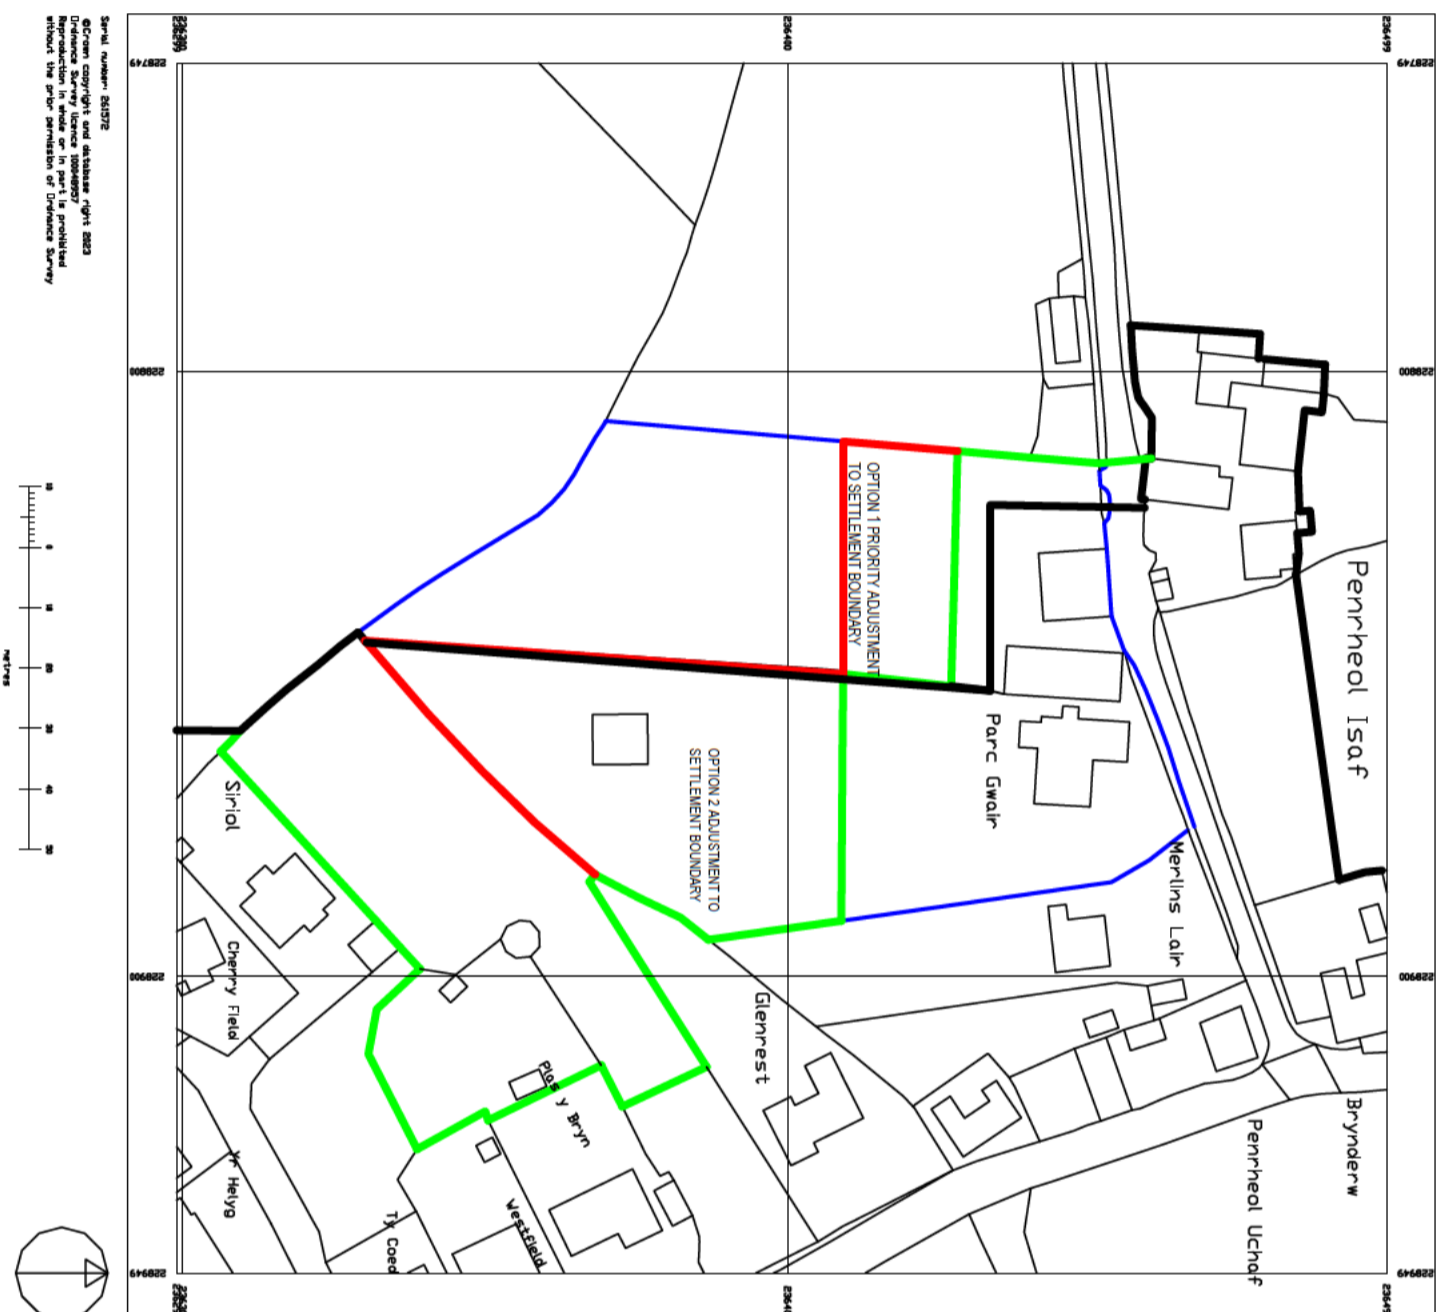

KEY:
 Black Line: Approx. LDP1 Settlement Boundary
 Green Line: Approx. Deposit LDP2 Settlement Boundary
 Red Line: Proposed adjustment to LDP2 Settlement Boundary
 Blue Line: Land Owned

Amendment	Date	Rev

Drawing Status
 Deposit LDP2 Comments

Client
 Mr Graham,

Site
 As above

Drawing Title
 Location Plan

Scale	Size	Drawn	Date
1:1250	A3	RLE	12/4/2023
Dwg No		Rev	
Loc1		-	

Serial number: 281272
